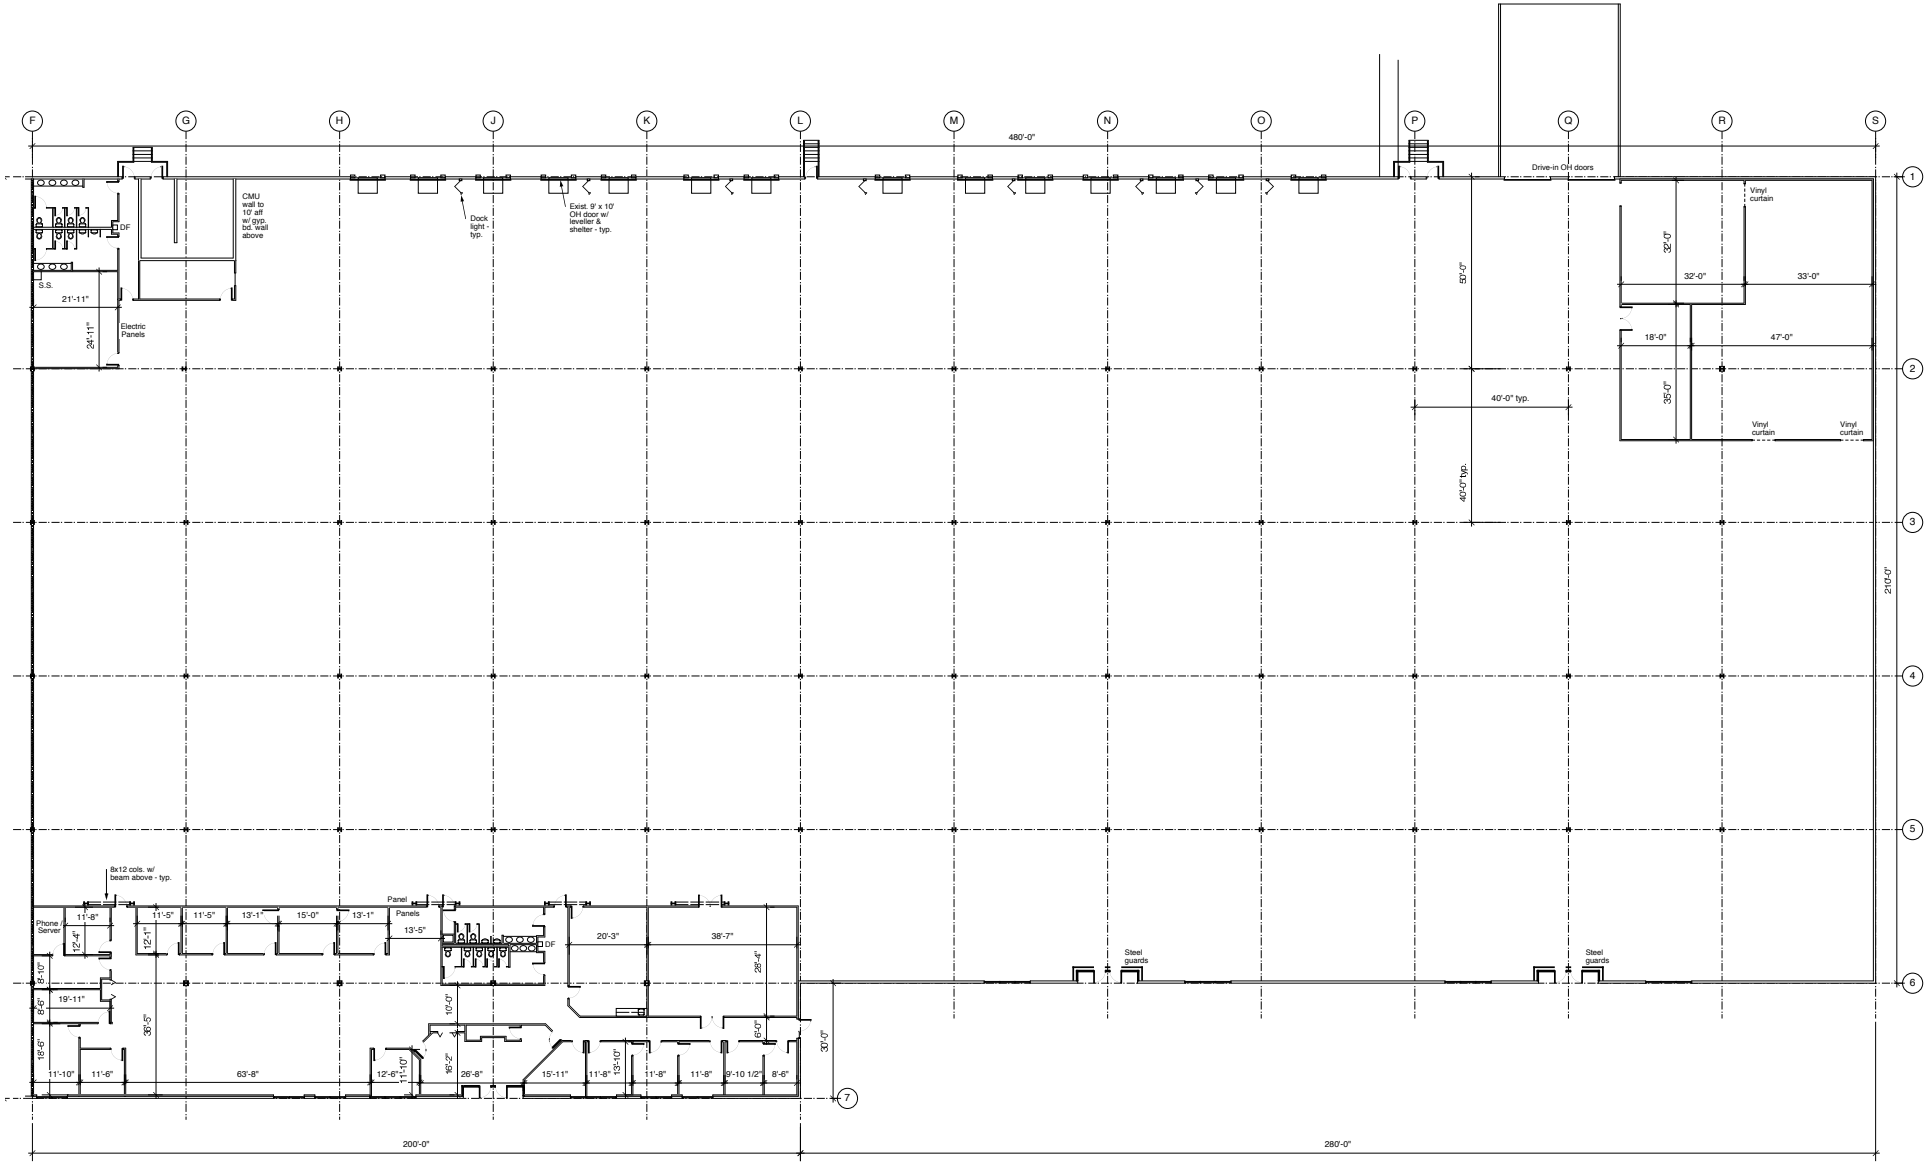

James Lloyd ARCHITECTS PA
12935 Byefield Drive, Highland, Maryland 20777 • 410 531 1177

As Built Floor Plan

6650 Business Perkway
Meadowridge Industrial Park
Elkridge, Maryland